


Many thanks to Runberg Architecture Group, Rushing, and DESC for their willingness to share this example code alteration/modification request used for the Hobson Place - South project. This document is provided as reference information only, and is not to be used for any other purpose. Code references, interpretations, and design criteria are all subject to your own design team and authority having jurisdiction (AHJ) interpretations.

MO.45

Additional Exhibit to accompany the HDC Exemplary Buildings Balanced Ventilation with Heat Recovery Guidelines

Many thanks to Runberg Architecture Group, Rushing, and DESC for their willingness to share this example code alteration/modification request used for the Hobson Place - South project. This document is provided as reference information only, and is not to be used for any other purpose. Code references, interpretations, and design criteria are all subject to your own design team and authority having jurisdiction (AHJ) interpretations.

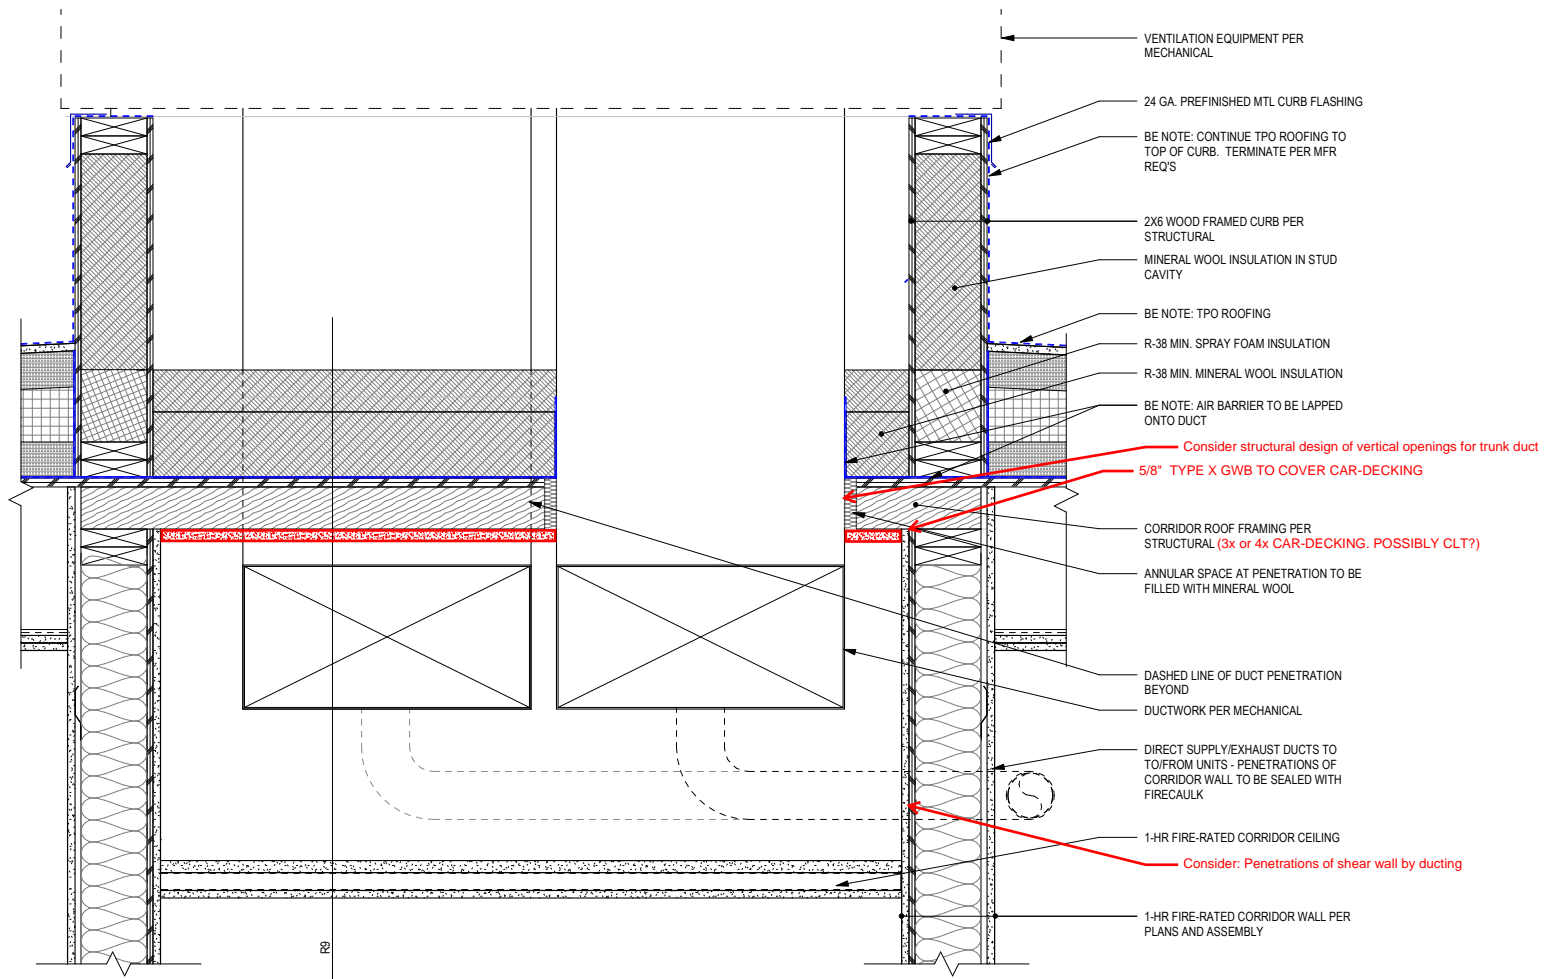

17 SECTION DTL - ROOF ERV EQUIPMENT SUPPORT CURB
A8.15 SCALE: 1 1/2" = 1'-0"

Callouts/Mark-ups in red added by EBTF